



3 CROSS SECTION- N.W. 7TH AVENUE
 SCALE: 3/32" = 1'-0"

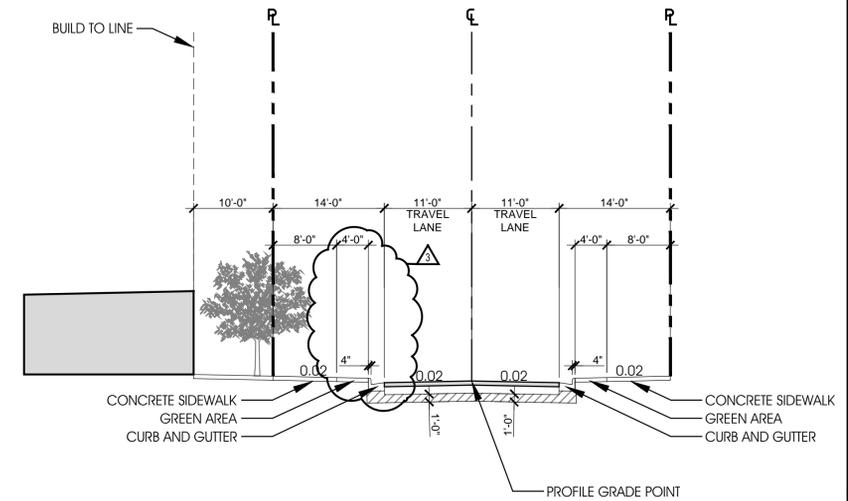

2 CROSS SECTION- N.W. 115TH STREET
 SCALE: 3/32" = 1'-0"

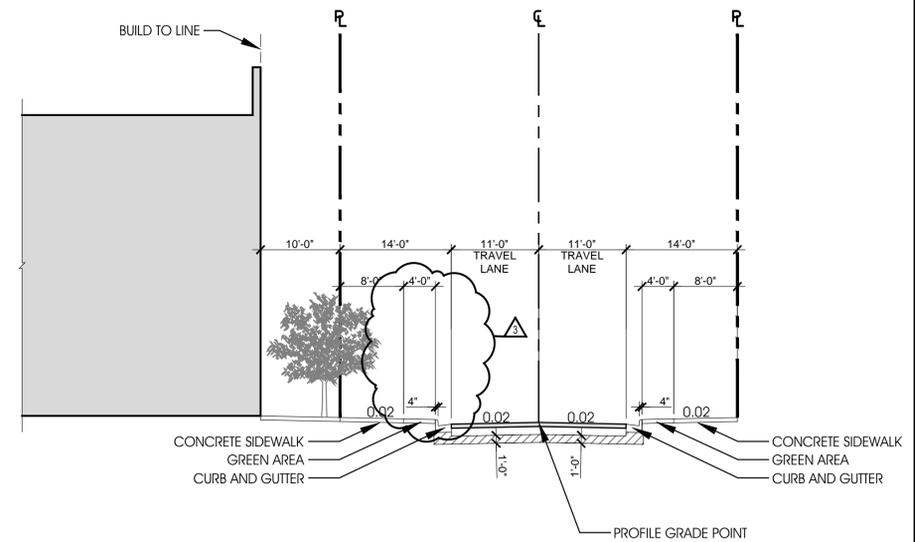

1 CROSS SECTION- N.W. 114TH STREET
 SCALE: 3/32" = 1'-0"

THRESHOLD BUILDING STATEMENT:
 I HEREBY CERTIFY THAT TO THE BEST OF MY KNOWLEDGE,
 THE PLANS AND SPECIFICATIONS COMPLY WITH THE
 APPLICABLE MINIMUM BUILDING CODES AND THE APPLICABLE
 FIRE SAFETY STANDARDS AS DETERMINED BY THE LOCAL
 AUTHORITY IN ACCORDANCE WITH THIS SECTION (1103.7-
 2014 FLORIDA BUILDING CODE) AND CHAPTER 633, FLORIDA
 STATUTES.

| NO. | DATE | ISSUE DESCRIPTION |
|-----|------------|-------------------------|
| 5 | 04/07/2016 | ISSUED FOR PERMIT |
| 4 | 12/14/2015 | ZONING REVIEW |
| 4 | 12/08/2015 | FIRE REVISIONS |
| 4 | 09/21/2015 | ADMIN SITE PLAN REVIEW |
| 3 | 09/04/2015 | APPLICATION CORRECTIONS |
| 2 | 08/12/2015 | PRE-APP. CORRECTIONS |
| 1 | 07/15/2015 | PRE-APPLICATION REVIEW |

COPYRIGHT 2016, SULLIVAN GOULETTE WILSON, LTD. EXPRESSLY
 RESERVES COMMON LAW COPYRIGHT AND OTHER PROPRIETARY RIGHTS
 IN THESE PLANS. THESE PLANS ARE NOT TO BE REPRODUCED, CHANGED
 OR COPIED IN ANY FORM OR MANNER UNLESS SO WRITTEN BY THE
 ARCHITECT OR ASSIGNED TO ANY THIRD PARTY. WITHOUT FIRST OBTAINING THE
 EXPRESS WRITTEN PERMISSION AND CONSENT OF SULLIVAN GOULETTE
 WILSON, LTD.

THESE DRAWINGS MAY HAVE BEEN REPRODUCED AT A SIZE DIFFERENTLY
 THAN ORIGINALLY DRAWN. OWNER AND ARCHITECT ASSUME NO
 RESPONSIBILITY FOR USE OF INCORRECT SCALE.

CONTRACTOR SHALL VERIFY ALL EXISTING CONDITIONS PRIOR TO
 PROCEEDING WITH CONSTRUCTION AND NOTIFY ARCHITECT
 IMMEDIATELY OF ANY DISCREPANCIES OR CONFLICTS.

PRINCIPAL: MS P.M.: DF
 QC BY: DC DRAWN BY: LWJH

**SULLIVAN
 GOULETTE
 & WILSON**




ARCHITECTS
 444 N. MICHIGAN AVENUE
 SUITE 1850
 CHICAGO, IL 60611
 Ph. 312.988.7412
 Fx. 312.988.7409
 www.sgwrch.com

STATE OF FLORIDA, DEPARTMENT OF
 BUSINESS AND PROFESSIONAL REGULATION
 License Number: AA26003181
 Expiration Date: February 28, 2017

**11459 NW 7th
 AVENUE**

MIAMI, FLORIDA 33168

STREET CROSS SECTIONS

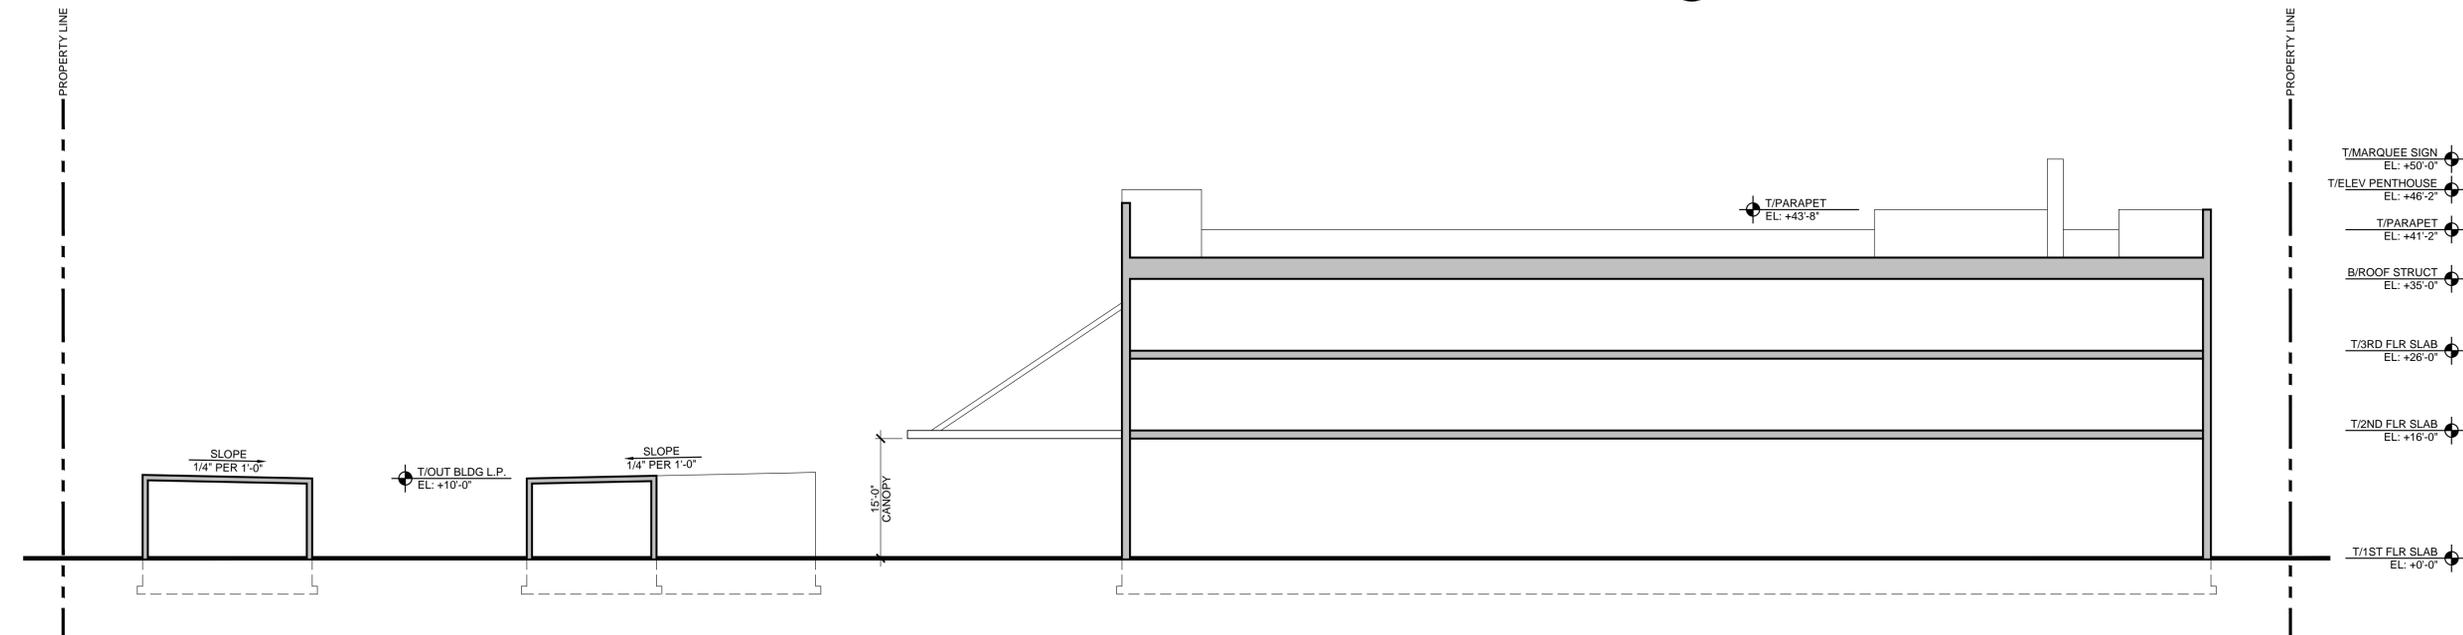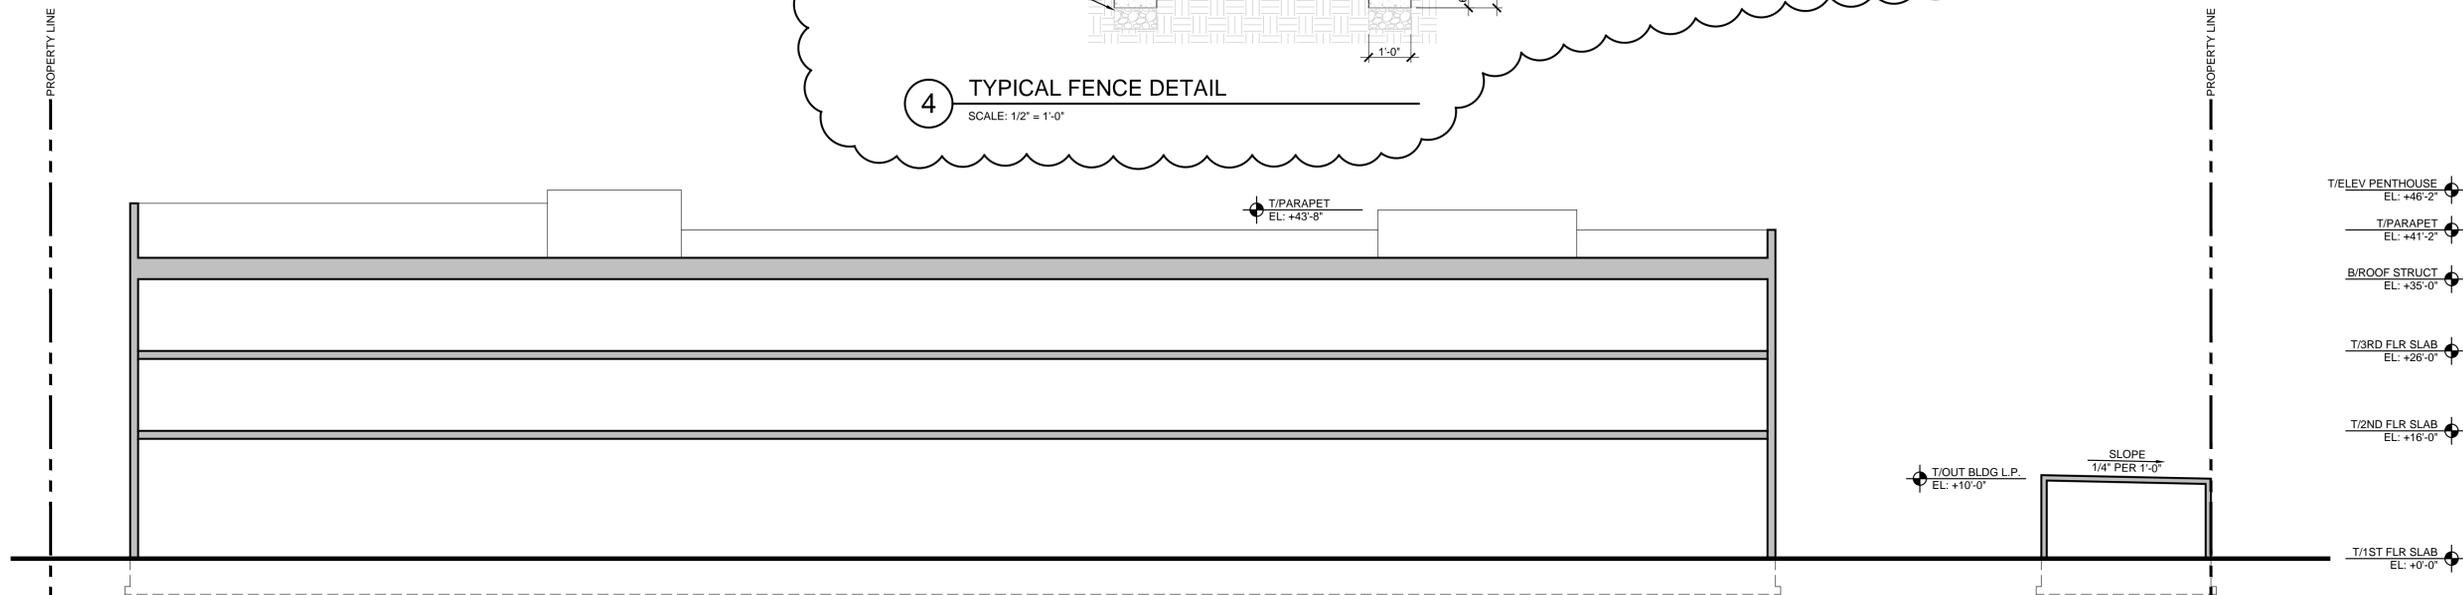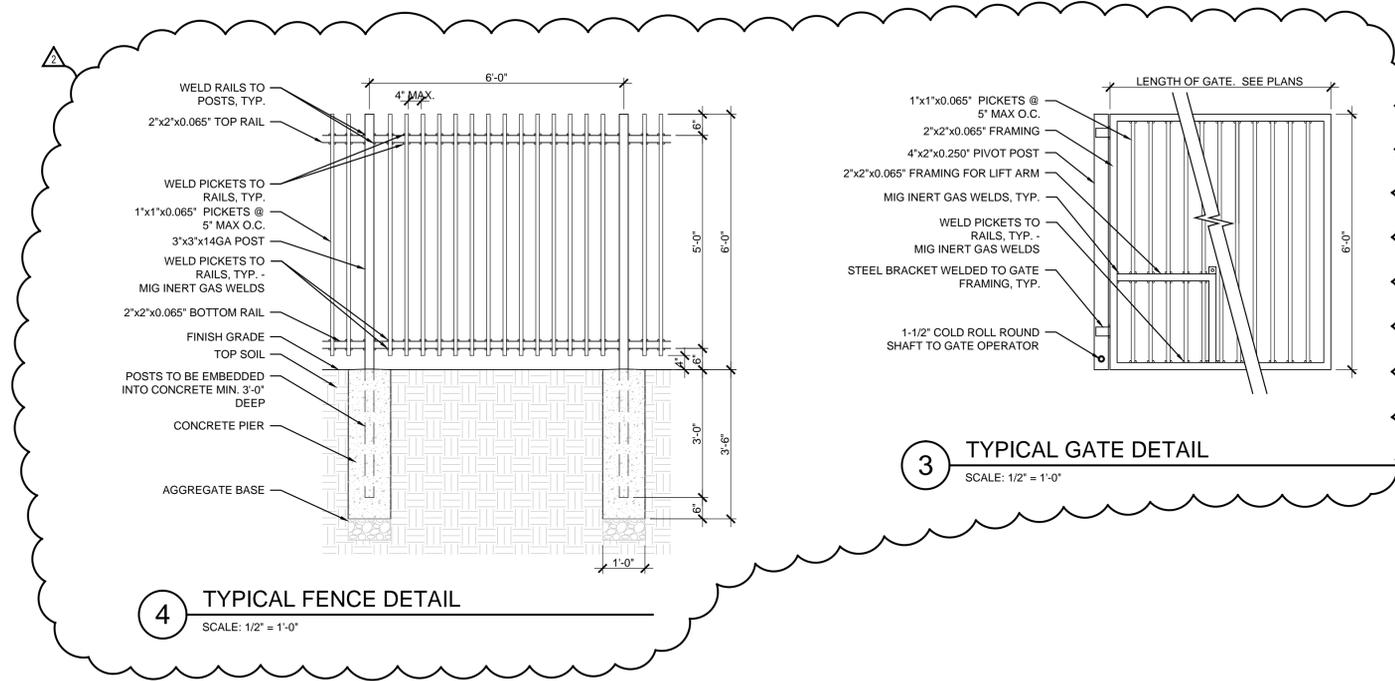

| | | |
|-----|------------|-------------------------|
| NO. | DATE | ISSUE DESCRIPTION |
| 1 | 07/15/2015 | PRE-APPLICATION REVIEW |
| 2 | 08/12/2015 | PRE-APP. CORRECTIONS |
| 3 | 09/04/2015 | APPLICATION CORRECTIONS |
| 4 | 09/21/2015 | ADMIN SITE PLAN REVIEW |
| 4 | 12/08/2015 | FIRE REVISIONS |
| △ | 12/14/2015 | ZONING REVIEW |

COPYRIGHT 2015 SULLIVAN GOULETTE WILSON LTD. EXPRESSLY RESERVES COMMON LAW COPYRIGHT AND OTHER PROPERTY RIGHTS IN THESE PLANS. THESE PLANS ARE NOT TO BE REPRODUCED, CHANGED OR COPIED IN ANY FORM OR MANNER UNLESS THEY ARE TO BE ASSIGNED TO ANY THIRD PARTY, WITHOUT FIRST OBTAINING THE EXPRESS WRITTEN PERMISSION AND CONSENT OF SULLIVAN GOULETTE WILSON LTD.

THESE DRAWINGS MAY HAVE BEEN REPRODUCED AT A SIZE DIFFERENT THAN ORIGINALLY DRAWN. OWNER AND ARCHITECT ASSUME NO RESPONSIBILITY FOR USE OF INCORRECT SCALE.

CONTRACTOR SHALL VERIFY ALL EXISTING CONDITIONS PRIOR TO PROCEEDING WITH CONSTRUCTION AND NOTIFY ARCHITECT IMMEDIATELY OF ANY DISCREPANCIES OR CONFLICTS.

PRINCIPAL: MS P.M.: CM
 QC BY: DRAWN BY: BM/EC

SULLIVAN GOULETTE & WILSON
 ARCHITECTS

444 N. MICHIGAN AVENUE
 SUITE 1850
 CHICAGO, IL 60611
 Ph. 312. 988. 7412
 Fx. 312. 988. 7409
 www.sgwarch.com

PROFESSIONAL DESIGN FIRM
 License Number: 184-001505
 Expiration Date: April 30, 2017

11459 NW 7th AVENUE

MIAMI, FLORIDA 33168

BUILDING SECTIONS AND DETAILS