


COPYRIGHT 1999 BELLON-MILANES ARCHITECTS, PLANNERS, INC. All ideas, designs, arrangements and plans indicated or represented by this drawing are owned by and are the property of BELLON-MILANES ARCHITECTS, PLANNERS, INC. and were created, evolved and developed for use on, and in connection with the specified project. These ideas, designs, arrangements and plans are not to be used, disclosed, reproduced, altered, copied or transferred in any form or manner whatsoever, without the specific written permission of BELLON-MILANES ARCHITECTS, PLANNERS, INC. Written permission on these drawings shall have precedence over indicated dimensions. Contractor shall have precedence over indicated dimensions. BELLON-MILANES ARCHITECTS, PLANNERS, INC. shall not be held responsible for any errors or omissions on these drawings. Field conditions shall prevail over field conditions provided for under the specific contractual agreement between the architect and the client. and cooperate with architect to modify work conditions at no additional cost. Shop details must be submitted to the architect's office and reviewed by architect. Prior to ordering materials, fabrication and delivery to the job site, unless otherwise provided for under the specific contractual agreement between the architect and the client.

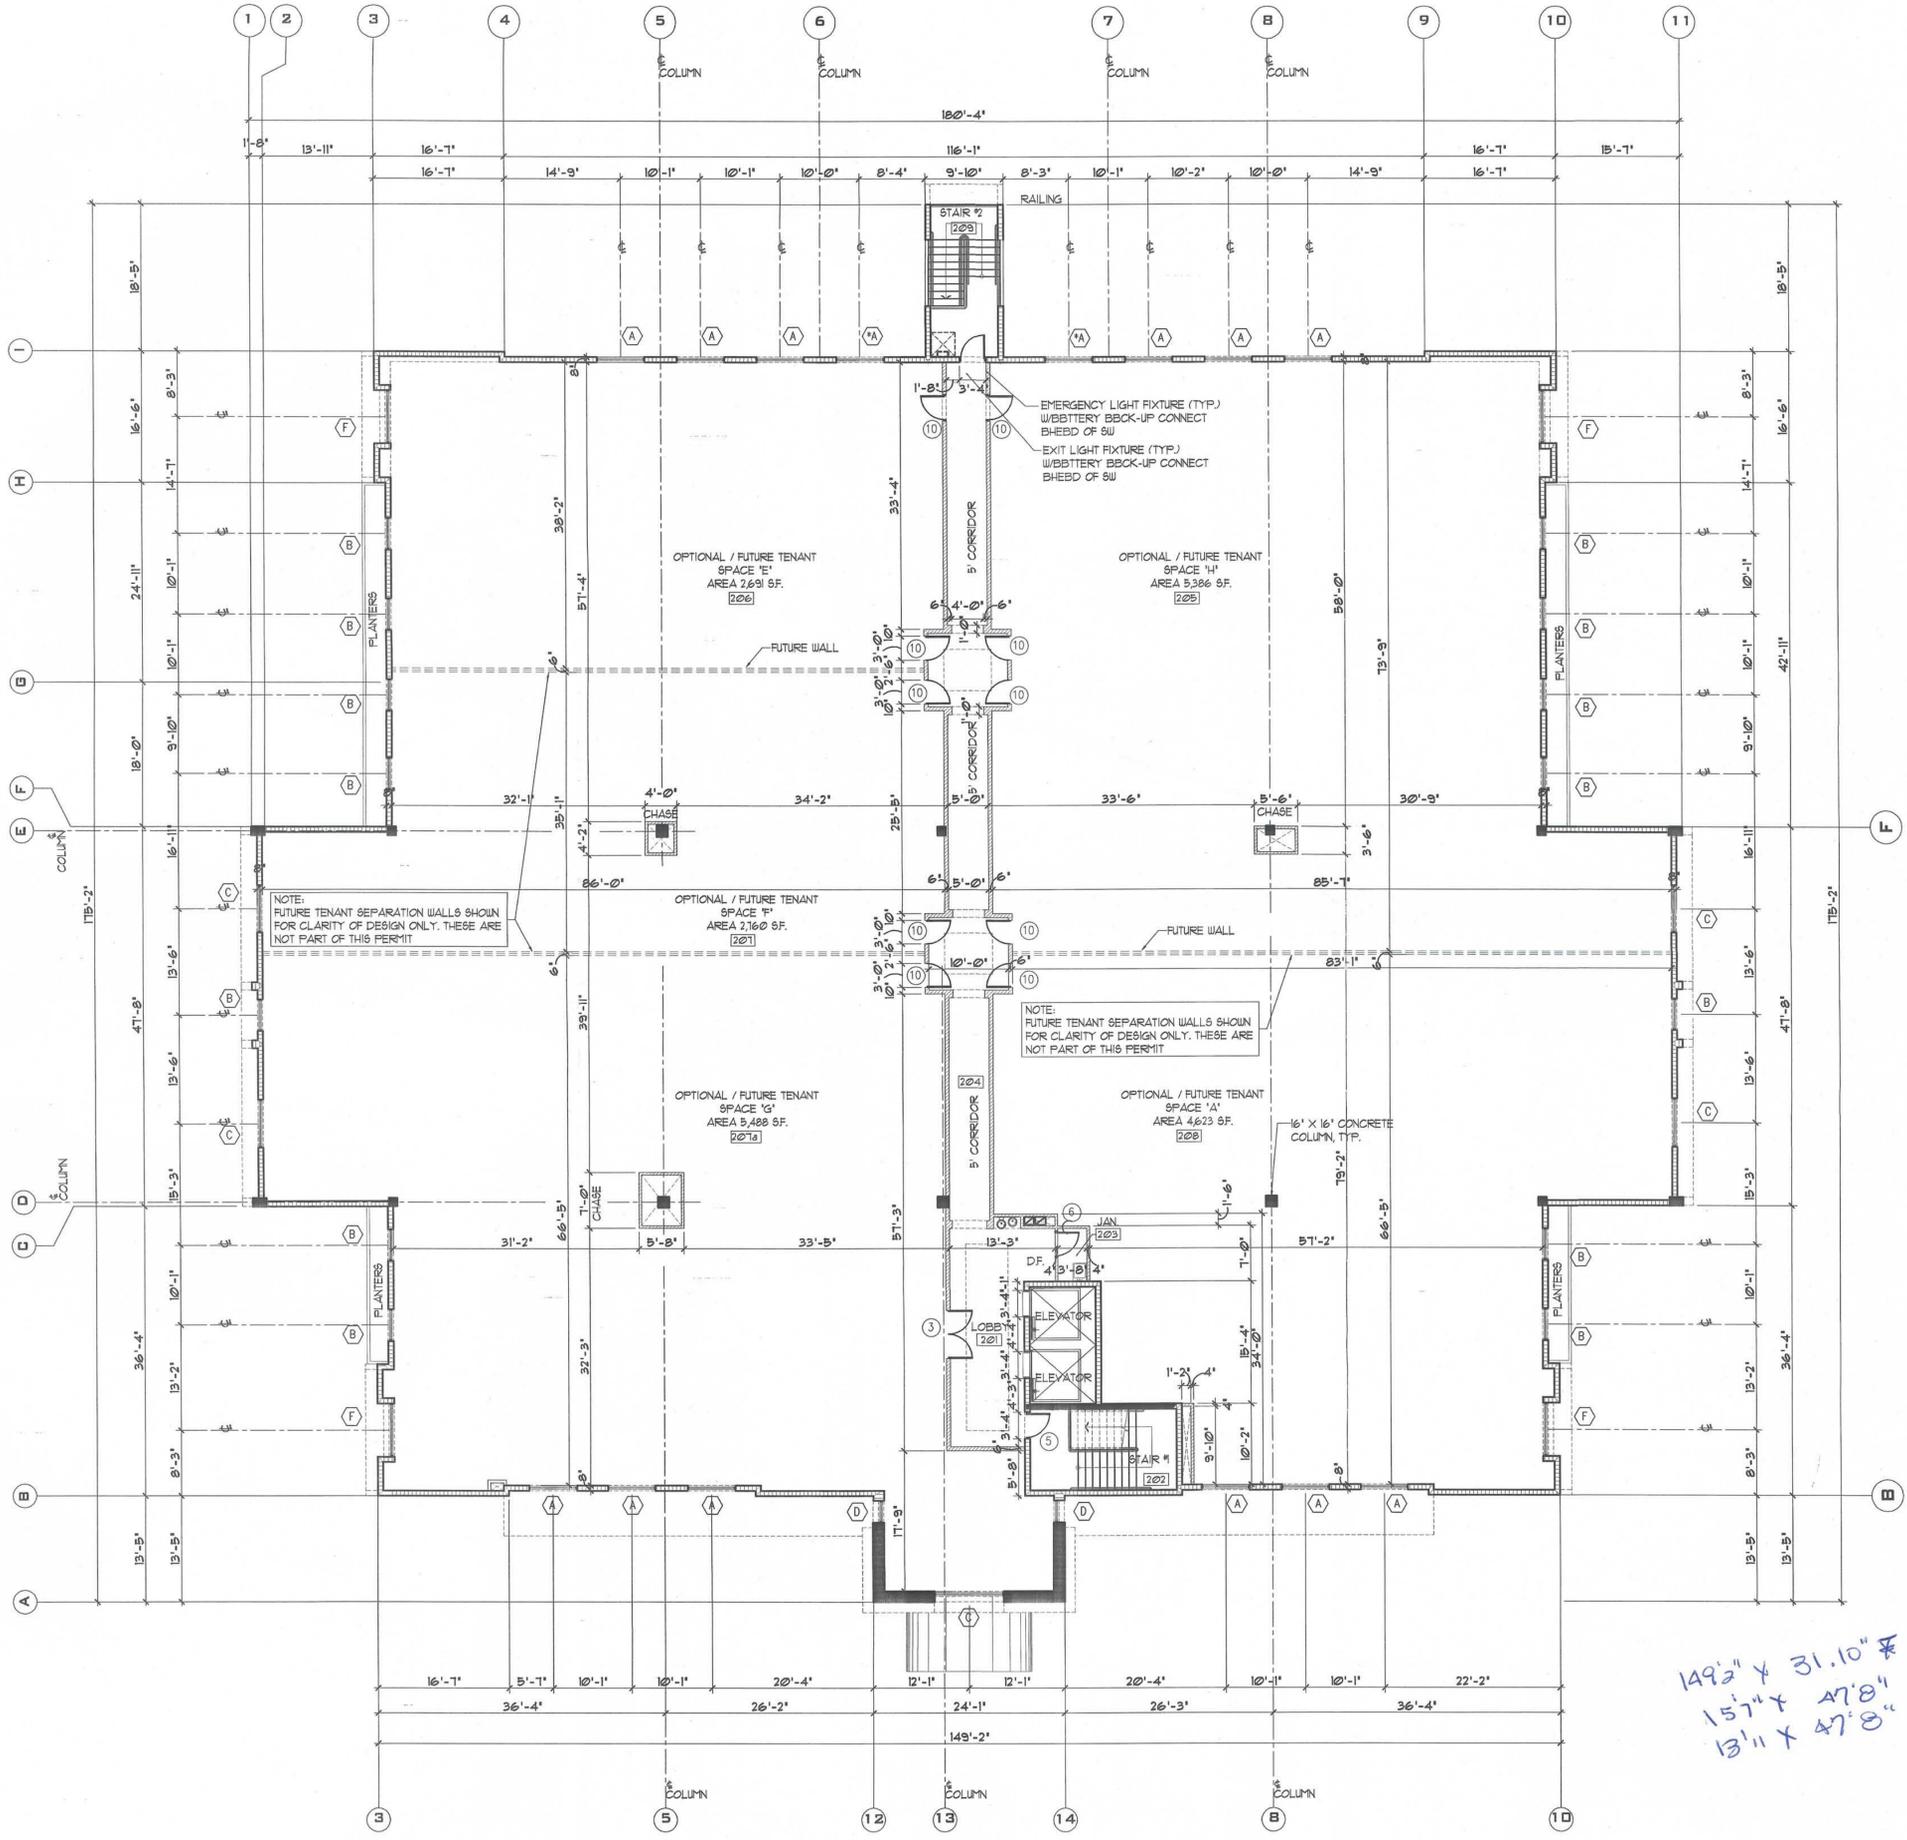

WALL LEGEND	
	DENOTES 8" REINFORCED MASONRY BEARING BLOCK WALL (PART OF THIS PERMIT)
	DENOTES FUTURE 1 HR FIRE RATED TENANT SEPARATION WALL (NOT PART OF THIS PERMIT)
	DENOTES 1 HR FIRE RATED PARTITION U.L. DESIGN #U465 No. 25 GAUGE CHANNEL SHAPE 3-5/8" STUDS 24" O.C. WITH ONE FULL "X" TYPE "X" 5/8" GYPSUM WALLBOARD APPLIED VERTICALLY ATTACHED WITH 1" LONG No. 6 LENGTH LAYER OF DRYWALL SCREWS TO EACH SIDE. SCREWS ARE 8" O.C. ALONG THE PERIMETER AND 12" O.C. ALONG THE INTERMEDIATE STUD.
	PARTITION: No. 25 GAUGE CHANNEL SHAPE 3-5/8" STUDS 16" O.C. WITH ONE FULL 5/8" GYPSUM WALLBOARD APPLIED VERTICALLY ATTACHED WITH 1" LONG No. 6 LENGTH LAYER OF DRYWALL SCREWS TO EACH SIDE. SCREWS ARE 8" O.C. ALONG THE PERIMETER AND 12" O.C. ALONG THE INTERMEDIATE STUD.
	CONCRETE COLUMN - SEE STRUCTURAL DRAWINGS

NOTE
 RESTROOMS ARE NOT PART OF THIS PERMIT. PLANS WILL BE SUBMITTED SEPARATELY @ TIME OF TENANT BUILDOUT.

NOTE
 THESE DRAWINGS ARE FOR SHELL PERMIT ONLY. INTERIOR PARTITIONS SHOWN (WITH THE EXCEPTION OF CORRIDOR PARTITIONS) ARE FUTURE AND ARE BEING INDICATED FOR CLARIFICATION / DESIGN PURPOSES ONLY. INTERIOR WORK IS NOT PART OF THIS PERMIT, (UNLESS OTHERWISE NOTED).

149'2" x 31.10" = 4768
 157' x 47'8" = 7428.5
 13'11" x 47'8" = 54
 6074 2nd fl

SECOND FLOOR PLAN
 SCALE: 3/32" = 1'-0"

GALLOWAY MEDICAL PAVILION
 SW 76TH STREET, 87TH AVENUE
 MIAMI-DADE COUNTY, FLORIDA

DATE: 05-15-06

DRAWN: AV/CB

CHECKED: AM

PROJ. NO: 2005EM469

- 1.
- 2.
- 3.

BDC: BUILDING DEPT. COMMENTS
 CC: COORDINATION CHANGES
 AB: AS-BUILT
 RAP: REVISION AFTER APPROVAL



ZONING HEARINGS SECTION
 MIAMI-DADE PLANNING AND ZONING DEPT.

LEOPOLDO BELLON, AIA
 AR-008737

ANGEL MILANES, AIA
 AR-0015845

SECOND FLOOR PLAN