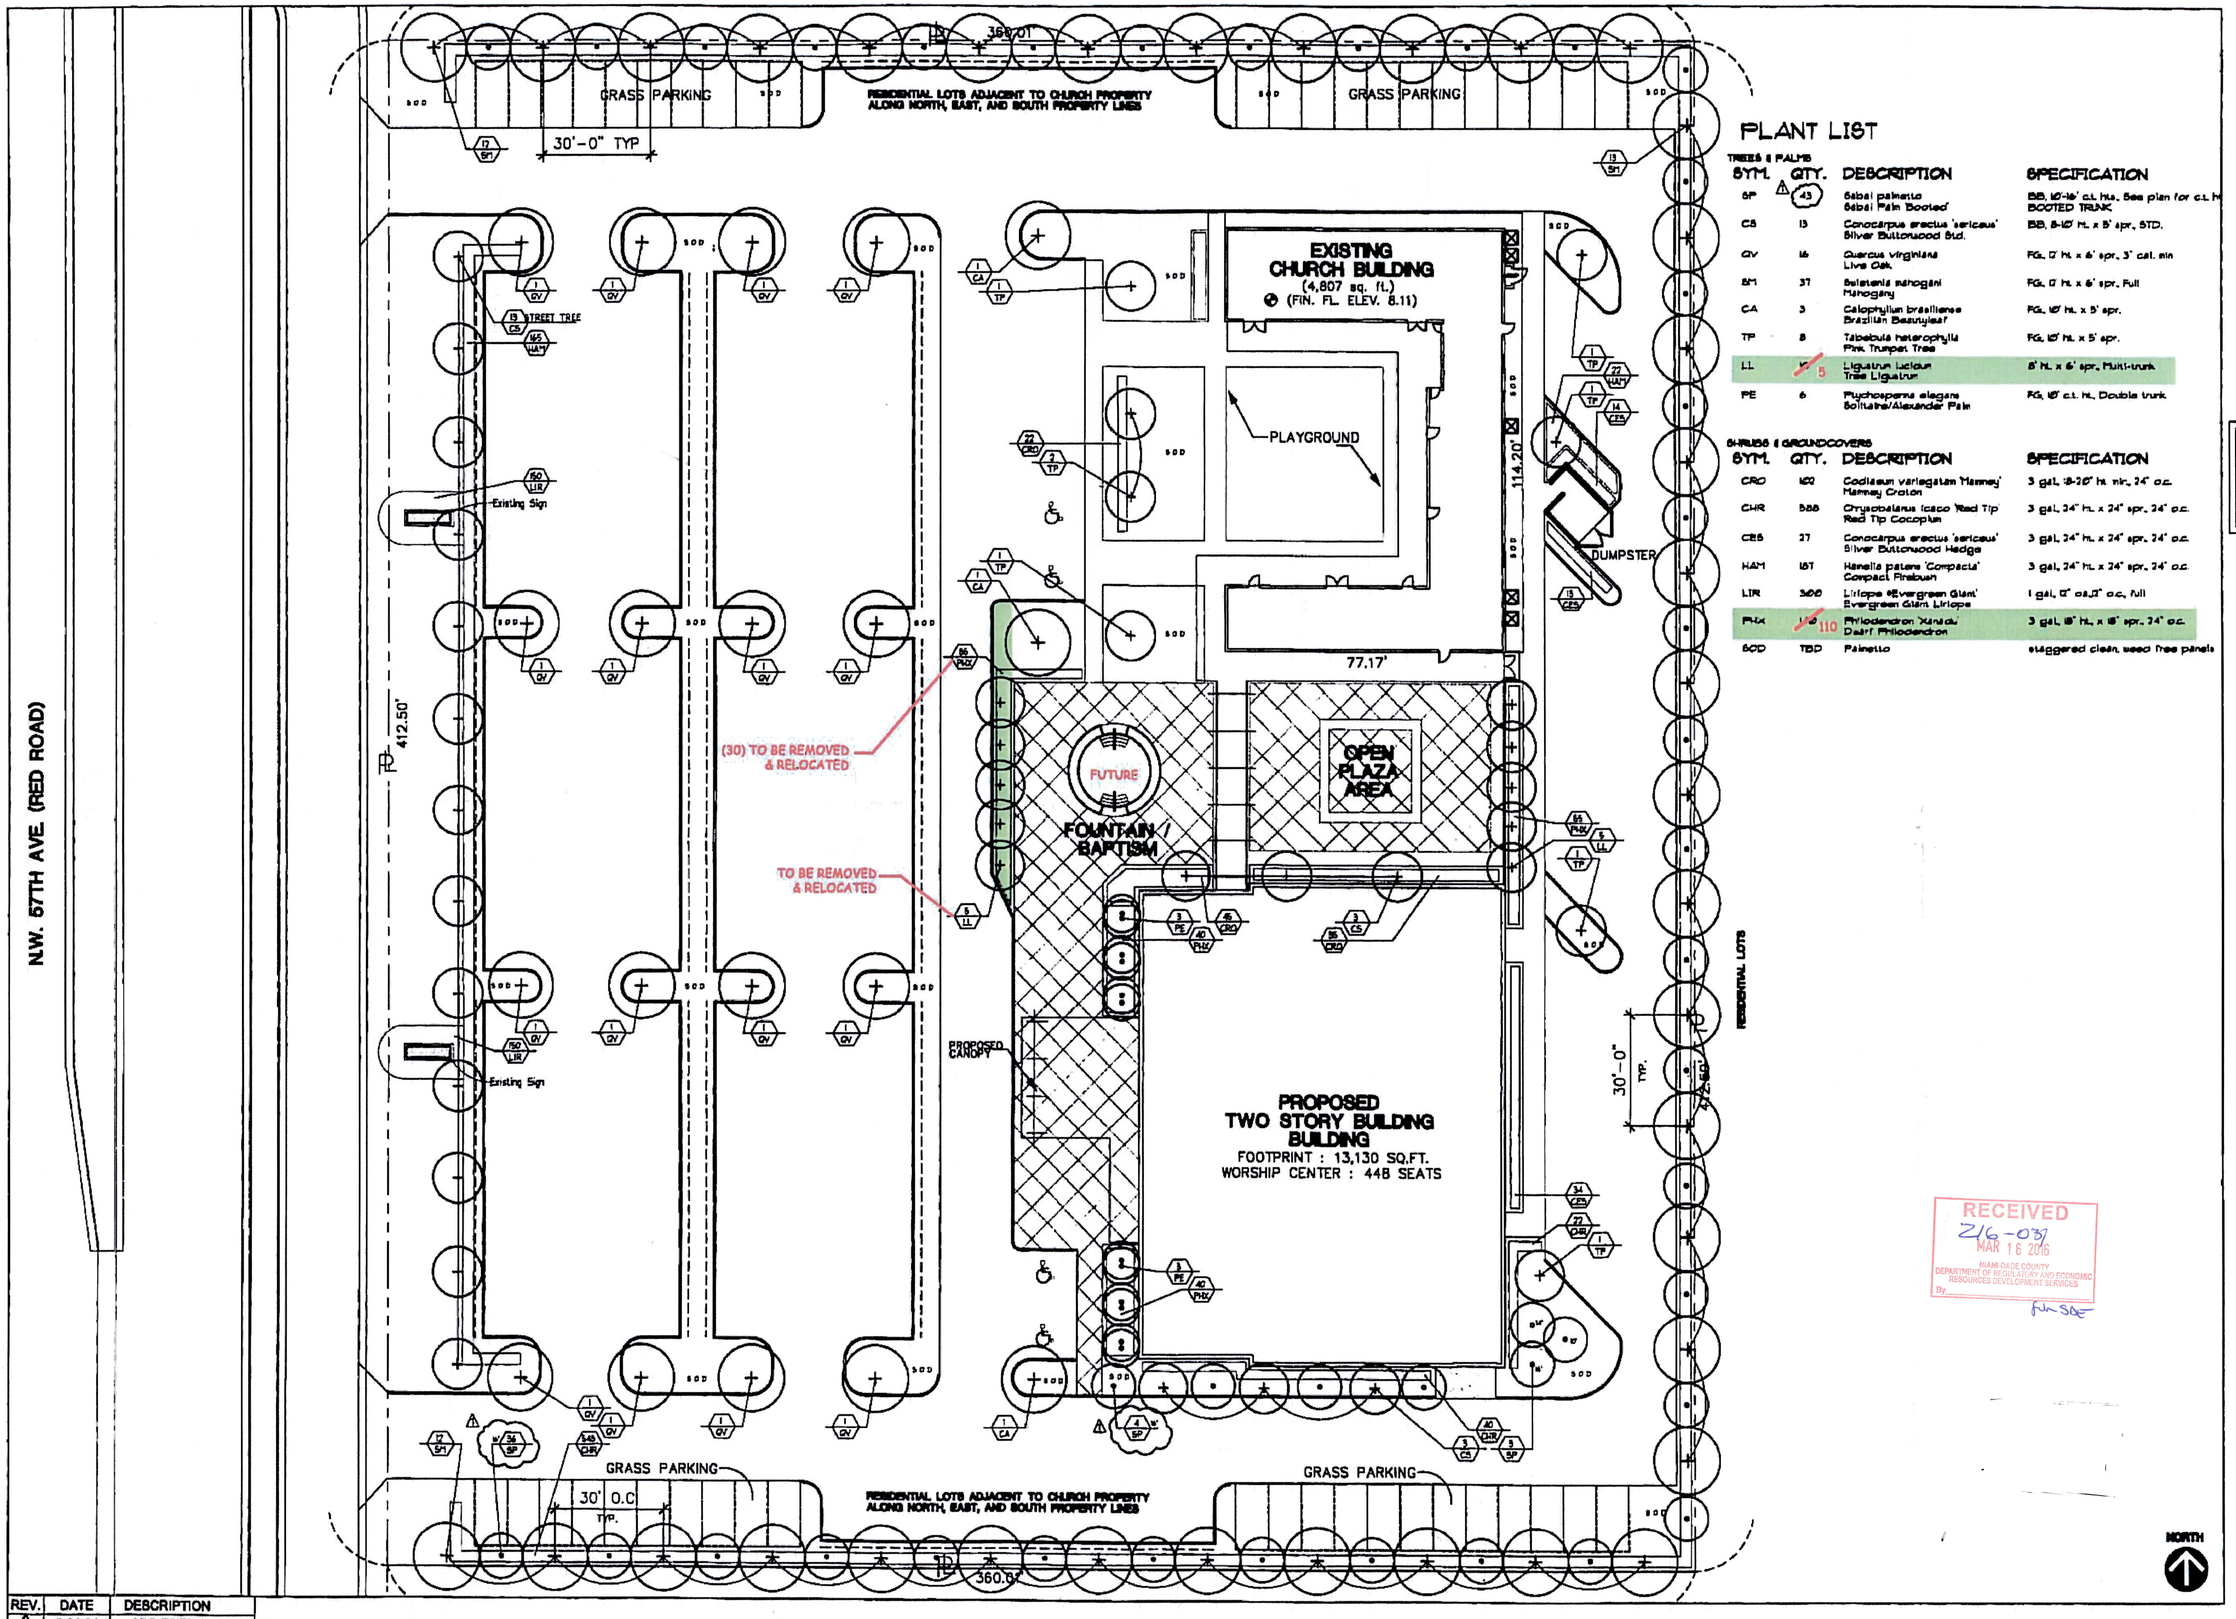

PLANT LIST

TREES & PALMS

SYM.	QTY.	DESCRIPTION	SPECIFICATION
SP	43	Sabal palmetto Sabal Palm 'Booted'	BB, 10'-16' c.t. hts. See plan for c.t. ht BOOTED TRUNK
CS	13	Conocarpus erectus 'sericeus' Silver Buttonwood Std.	BB, 8-10' ht. x 5' spr., STD.
QV	16	Quercus virginiana Live Oak	FG, 12' ht. x 6' spr., 3" cal. min
SM	37	Swietenia mahogani Mahogany	FG, 12' ht. x 6' spr., Full
CA	3	Calophyllum brasiliense Brazilian Beautyleaf	FG, 10' ht. x 5' spr.
TP	8	Tabebuia heterophylla Pink Trumpet Tree	FG, 10' ht. x 5' spr.
LL	~~12~~ 5	Ligustrum lucidum Tree Ligustrum	8' ht. x 6' spr., Multi-trunk
PE	6	Ptychosperma elegans Solitaire/Alexander Palm	FG, 10' c.t. ht., Double trunk

SHRUBS & GROUNDCOVERS

SYM.	QTY.	DESCRIPTION	SPECIFICATION
CRO	102	Codiaeum variegatum 'Mammey' Mammey Croton	3 gal., 18-20" ht. min., 24" o.c.
CHR	588	Chrysobalanus icaco 'Red Tip' Red Tip Cocoplum	3 gal., 24" ht. x 24" spr., 24" o.c.
CES	27	Conocarpus erectus 'sericeus' Silver Buttonwood Hedge	3 gal., 24" ht. x 24" spr., 24" o.c.
HAM	157	Hamelia patens 'Compacta' Compact Firebush	3 gal., 24" ht. x 24" spr., 24" o.c.
LIR	300	Liriope 'Evergreen Giant' Evergreen Giant Liriope	1 gal., 12" o.a., 12" o.c., full
PHX	~~120~~ 110	Philodendron 'Xanadu' Dwarf Philodendron	3 gal., 18" ht. x 18" spr., 24" o.c.
SOD	TBD	Palmetto	staggered clean, weed free panels

RECEIVED
216-037
MAR 16 2016
MIAMI-DADE COUNTY
DEPARTMENT OF REGULATORY AND ECONOMIC RESOURCES DEVELOPMENT SERVICES
By

REV.	DATE	DESCRIPTION
1	6-24-04	ADD TREES

LAND FORM design group

LAND FORM DESIGN GROUP, INC.
5079 N. Dixie Highway No. 260
Fort Lauderdale, FL 33334
TEL 954.533.1020
FAX 954.533.1020
Email malcolmem@comcast.net

CONSULTANTS

PLAN REVIEW BY:

THOMAS WHITE, RLA
LANDSCAPE ARCHITECT # LA1000
2600 NE 27th AVENUE
FORT LAUDERDALE, FLORIDA 33306
954-566-0585

ARCHITECT

jerry clawson/ architect

2101 W. CYPRESS CREEK ROAD
FT. LAUDERDALE, FLORIDA 33309
954. 315. 4394 FAX 954. 315. 4395
license no. ar-0012262

PROJECT

INTERNATIONAL BIBLE BAPTIST CHURCH

17701 N.W. 57 AVE.
MIAMI, FLORIDA

KEY MAP

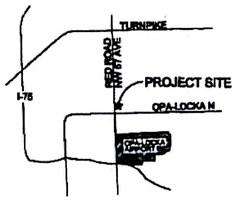

ISSUED FOR:

- REVIEW & COMMENTS
- BIDDING
- PERMIT
- NOT FOR CONSTRUCTION
- CONSTRUCTION

DRAWN: MM
CHECKED: TW
SCALE: 1" = 20'-0"
JOB NO.: INT-BB
DATE: 11-10-03

SEAL

DRAWING TITLE:

LANDSCAPE PLAN

SHEET NO.:
L-002
SHEET 02 OF 03

©LAND FORM DESIGN GROUP INC. ALL RIGHTS RESERVED